



AS BUILT

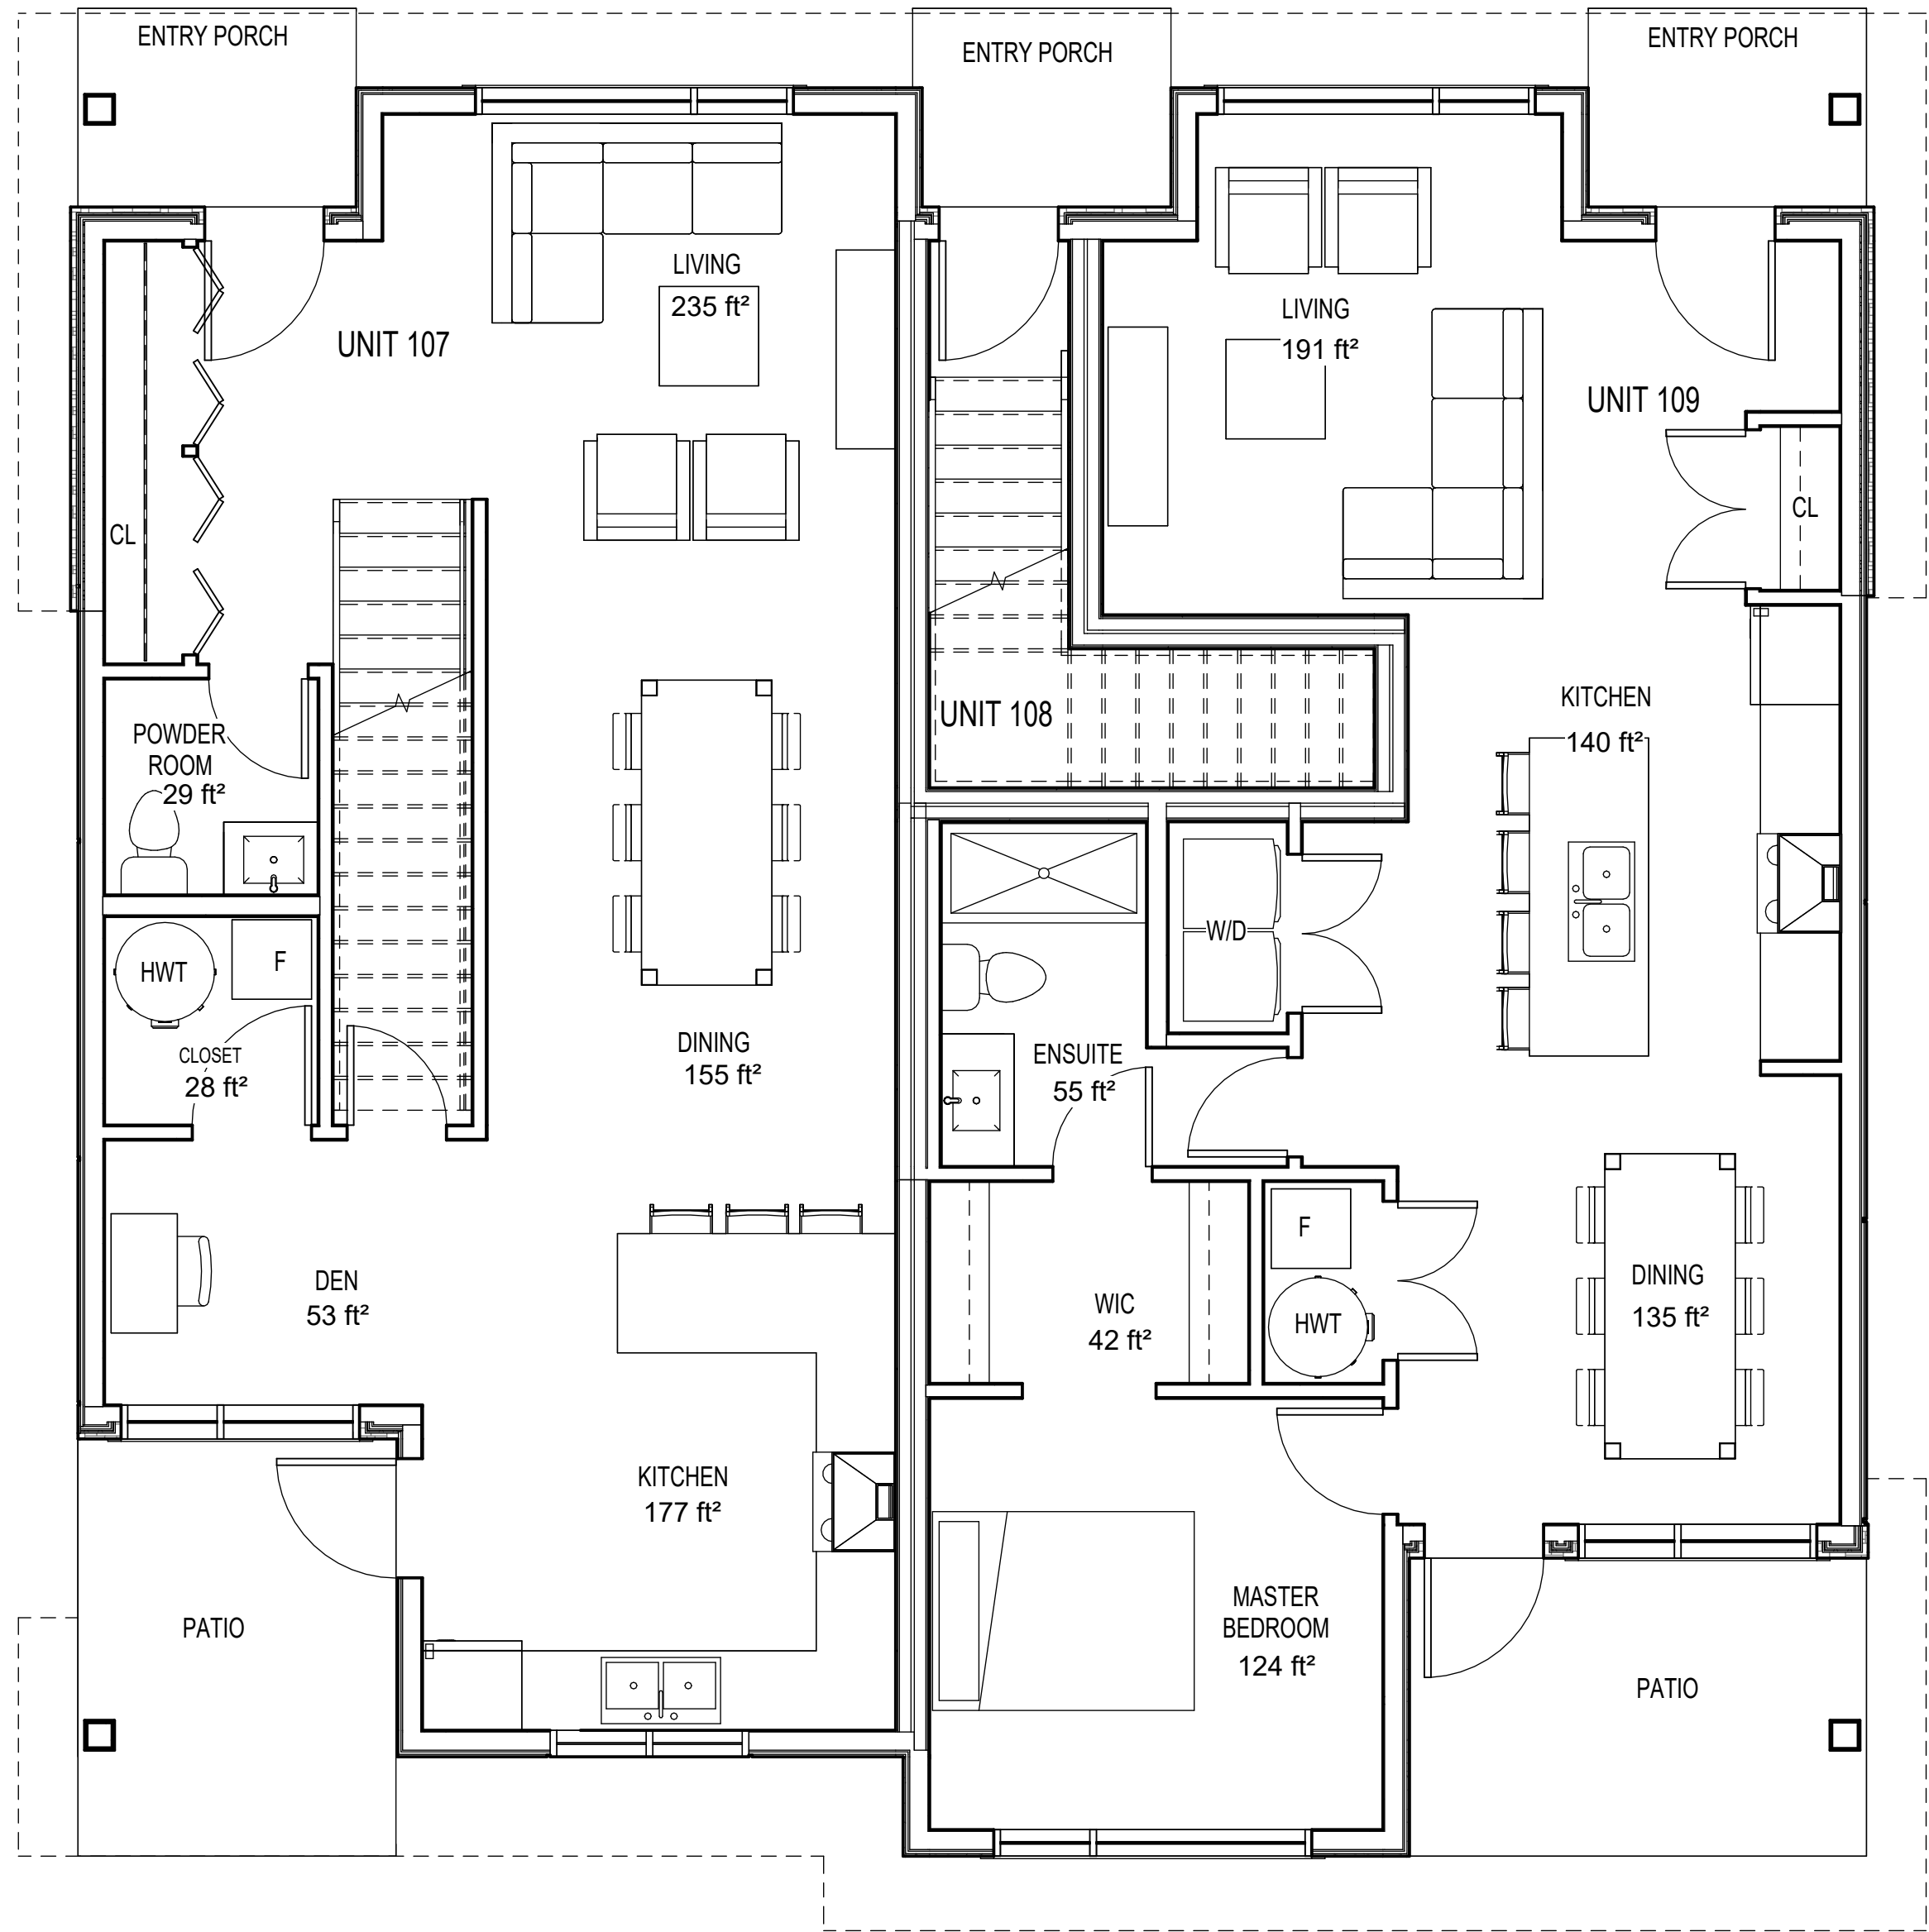

1 LEVEL 1
1/4" = 1'-0"

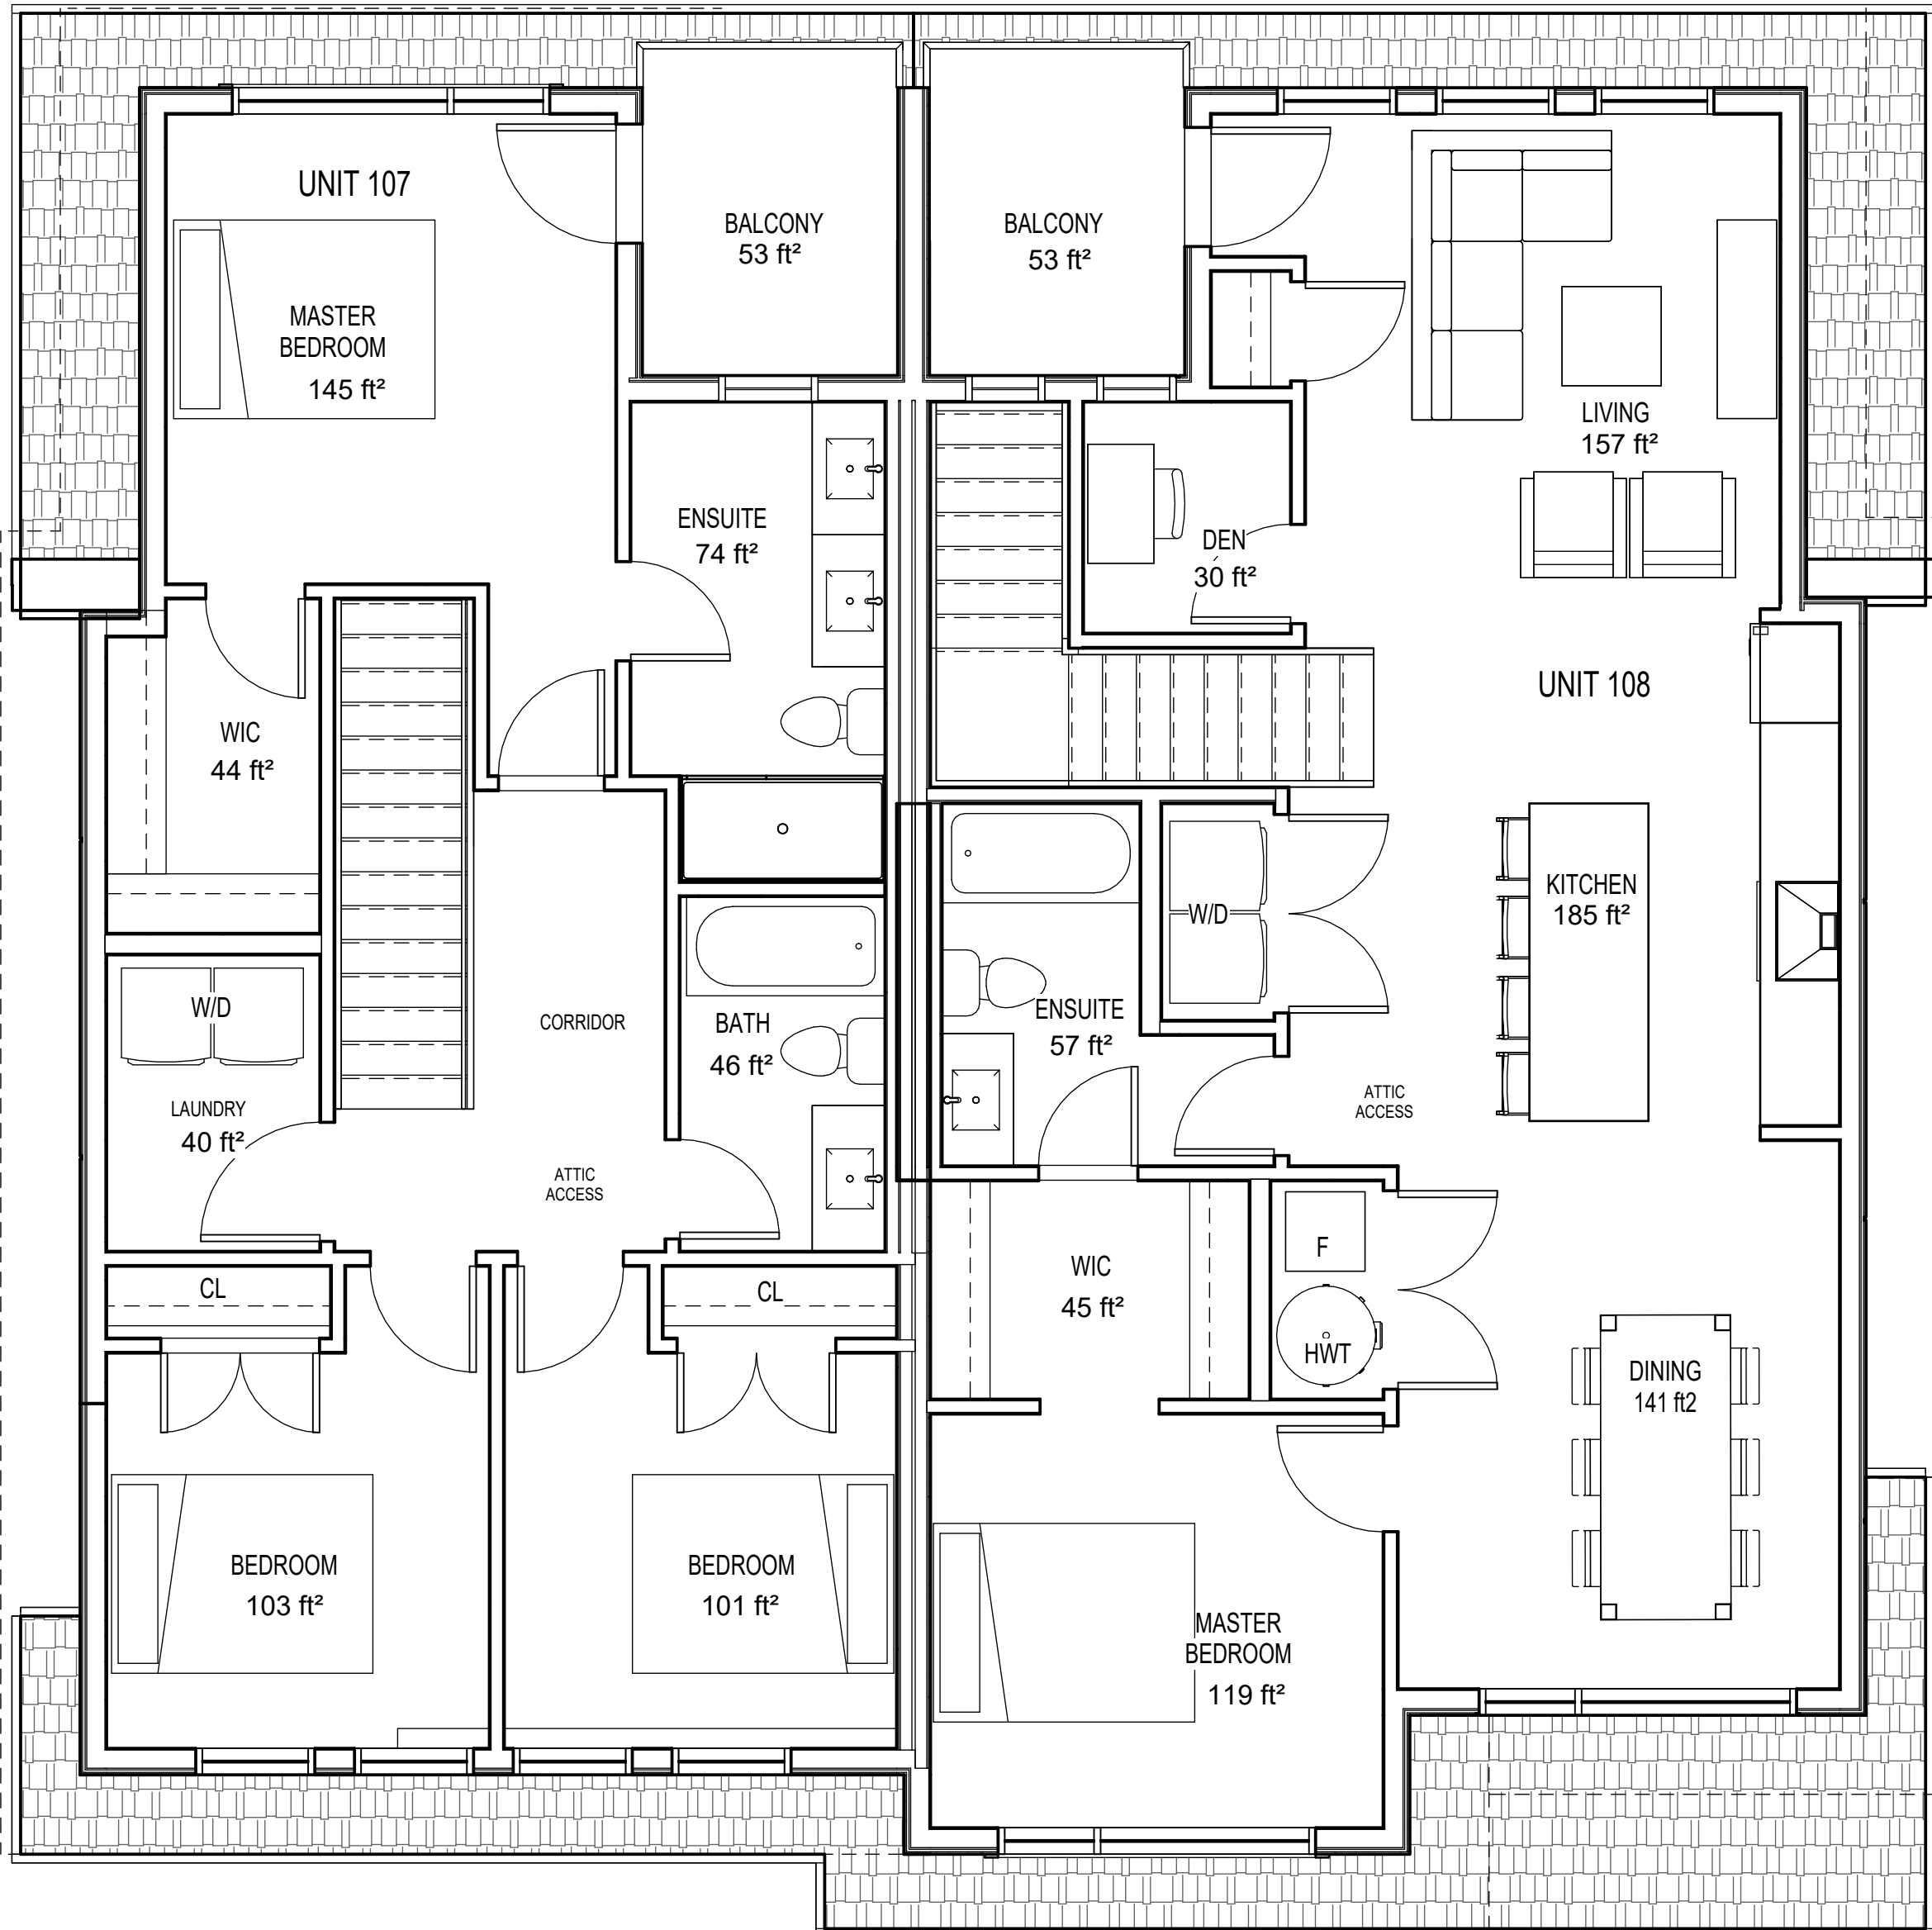

2 LEVEL 2
1/4" = 1'-0"

REV.	DD-MM-YYYY	ISSUE DESCRIPTION	DRAWN	REVIEWED
------	------------	-------------------	-------	----------

THE DRAWING MUST NOT BE SCALED.
THE GENERAL CONTRACTOR SHALL VERIFY DIMENSIONS, LEVELS & DATA NOTED HEREIN WITH THE CONDITIONS ON-SITE AND IS HELD RESPONSIBLE FOR REPORTING ANY DISCREPANCY OR OMISSION TO THE ARCHITECT IMMEDIATELY PRIOR TO COMMENCEMENT OF WORK.

COPYRIGHT RESERVED. THIS DRAWING AS AN INSTRUMENT OF SERVICE AND EXCLUSIVE PROPERTY OF THE ARCHITECT AND MAY BE REPRODUCED ONLY WITH THE WRITTEN PERMISSION OF VIVID GREEN ARCHITECTURE INC.

PROJECT:

Multi-Family Residential

834 Park Road
Gibsons, BC

ARCHITECTURAL

BLDG 3 - FLOOR PLAN

REVIEWED	RS	SEAL
DRAWN	RA/STAR	
SCALE	1/4" = 1'-0"	
START DATE	22/08/22	
	SHEET ISSUE DATE 30 JUNE 2026	

PROJECT NO.	DRAWING NO.	REV. NO.
2111GIB	A103	